

# KENDALL COUNTY



DEPARTMENT OF  
DEVELOPMENT MANAGEMENT  
211 East San Antonio Street, Suite 6  
Boerne, Texas 78006  
Telephone: (A/C) 249-9343 Ext. 23

FILE NO. S- 2994

## SEPTIC FORM

PRIVATE SEWAGE FACILITY (LICENSED) IN KENDALL COUNTY, TEXAS

### APPLICANT INFORMATION:

PROPERTY OWNER (LICENSEE) GARY PAGE CONTRACTOR BOHWERT

SUBDIVISION OR LOCATION GRANDVIEW ACRES, LOT 11

216 WALNUT RD.

TOTAL AREA SQ. FT. \_\_\_\_\_ OR ACRES 10.0

NO. BEDROOMS 2 OR SQ. FT. OF HOUSE \_\_\_\_\_ OR GAL/DAY 275

PERC RATE .6 GAL/D CLASS NO. \_\_\_\_\_ TRENCH REQ. SQ. FT. 390 OR BED REQ. SQ. FT. \_\_\_\_\_


GALLON CAPACITY REQ. FOR CONCRETE SEPTIC TANK 1000 GAL

INSTALLED: LENGTH 137 WIDTH 3

SQ. FT. 396 BED \_\_\_\_\_ TRENCH ✓

REMARKS: She will has not been drilled yet.

(SKETCH OF APPROXIMATE DISTANCES, NOT TO SCALE.)

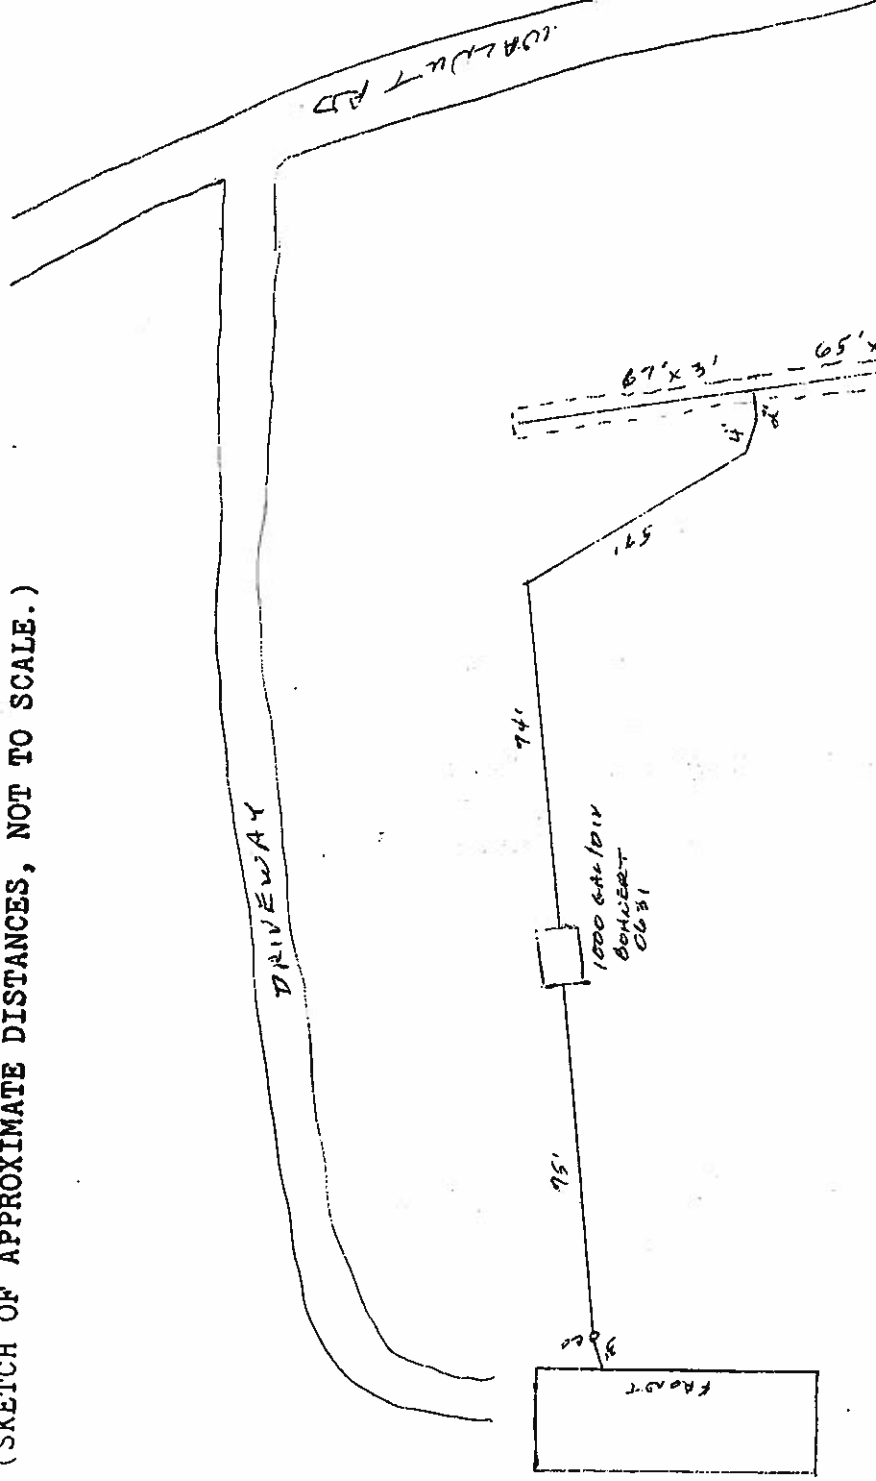

THE COUNTY OF KENDALL, THE TEXAS DEPARTMENT OF HEALTH, OR THEIR AGENTS OR DESIGNEES, MAKE NO REPRESENTATION THAT FACILITIES HEREIN LICENSED WILL PROVIDE SATISFACTORY SERVICE TO THE PREMISES SERVED. IT WILL BE THE LICENSEE'S RESPONSIBILITY TO MAKE ANY CHANGES OR MODIFICATIONS WHICH OPERATING EXPERIENCE MAY SHOW TO BE NECESSARY IN ORDER FOR THESE FACILITIES TO PROVIDE SATISFACTORY SERVICE. SEPTIC DISTANCES MEET MINIMUM TEXAS DEPARTMENT OF HEALTH SEPARATION DISTANCES IN MOST INSTANCES, SOME RENOVATIONS MAY BE LESS IF REPAIRED OR REPLACED IN THE SAME GENERAL AREA AS THE PRE-EXISTING SYSTEM BEING RENOVATED.  
PERMIT (LICENSE) GRANTED AND APPROVED THIS DATE: 18 OCT. 96

JOHN B. DUNKIN, DIRECTOR OF DEVELOPMENT MGT  
Kendall County  
LEON BRIMHALL, ASSISTANT